



**TACOMA'S  
 HISTORIC  
 ELKS LODGE**

AS-BUILT SET 2007

565 BROADWAY  
 TACOMA, WA 98402

Parcel No. 2005050080  
 2005050070  
 2005050060  
 & 2005050050

**PROGRESS  
 SET**


Project No. 07-002.01

Date: September 15, 2007

Revisions


Key Plan

**SECOND  
 FLOOR PLAN**

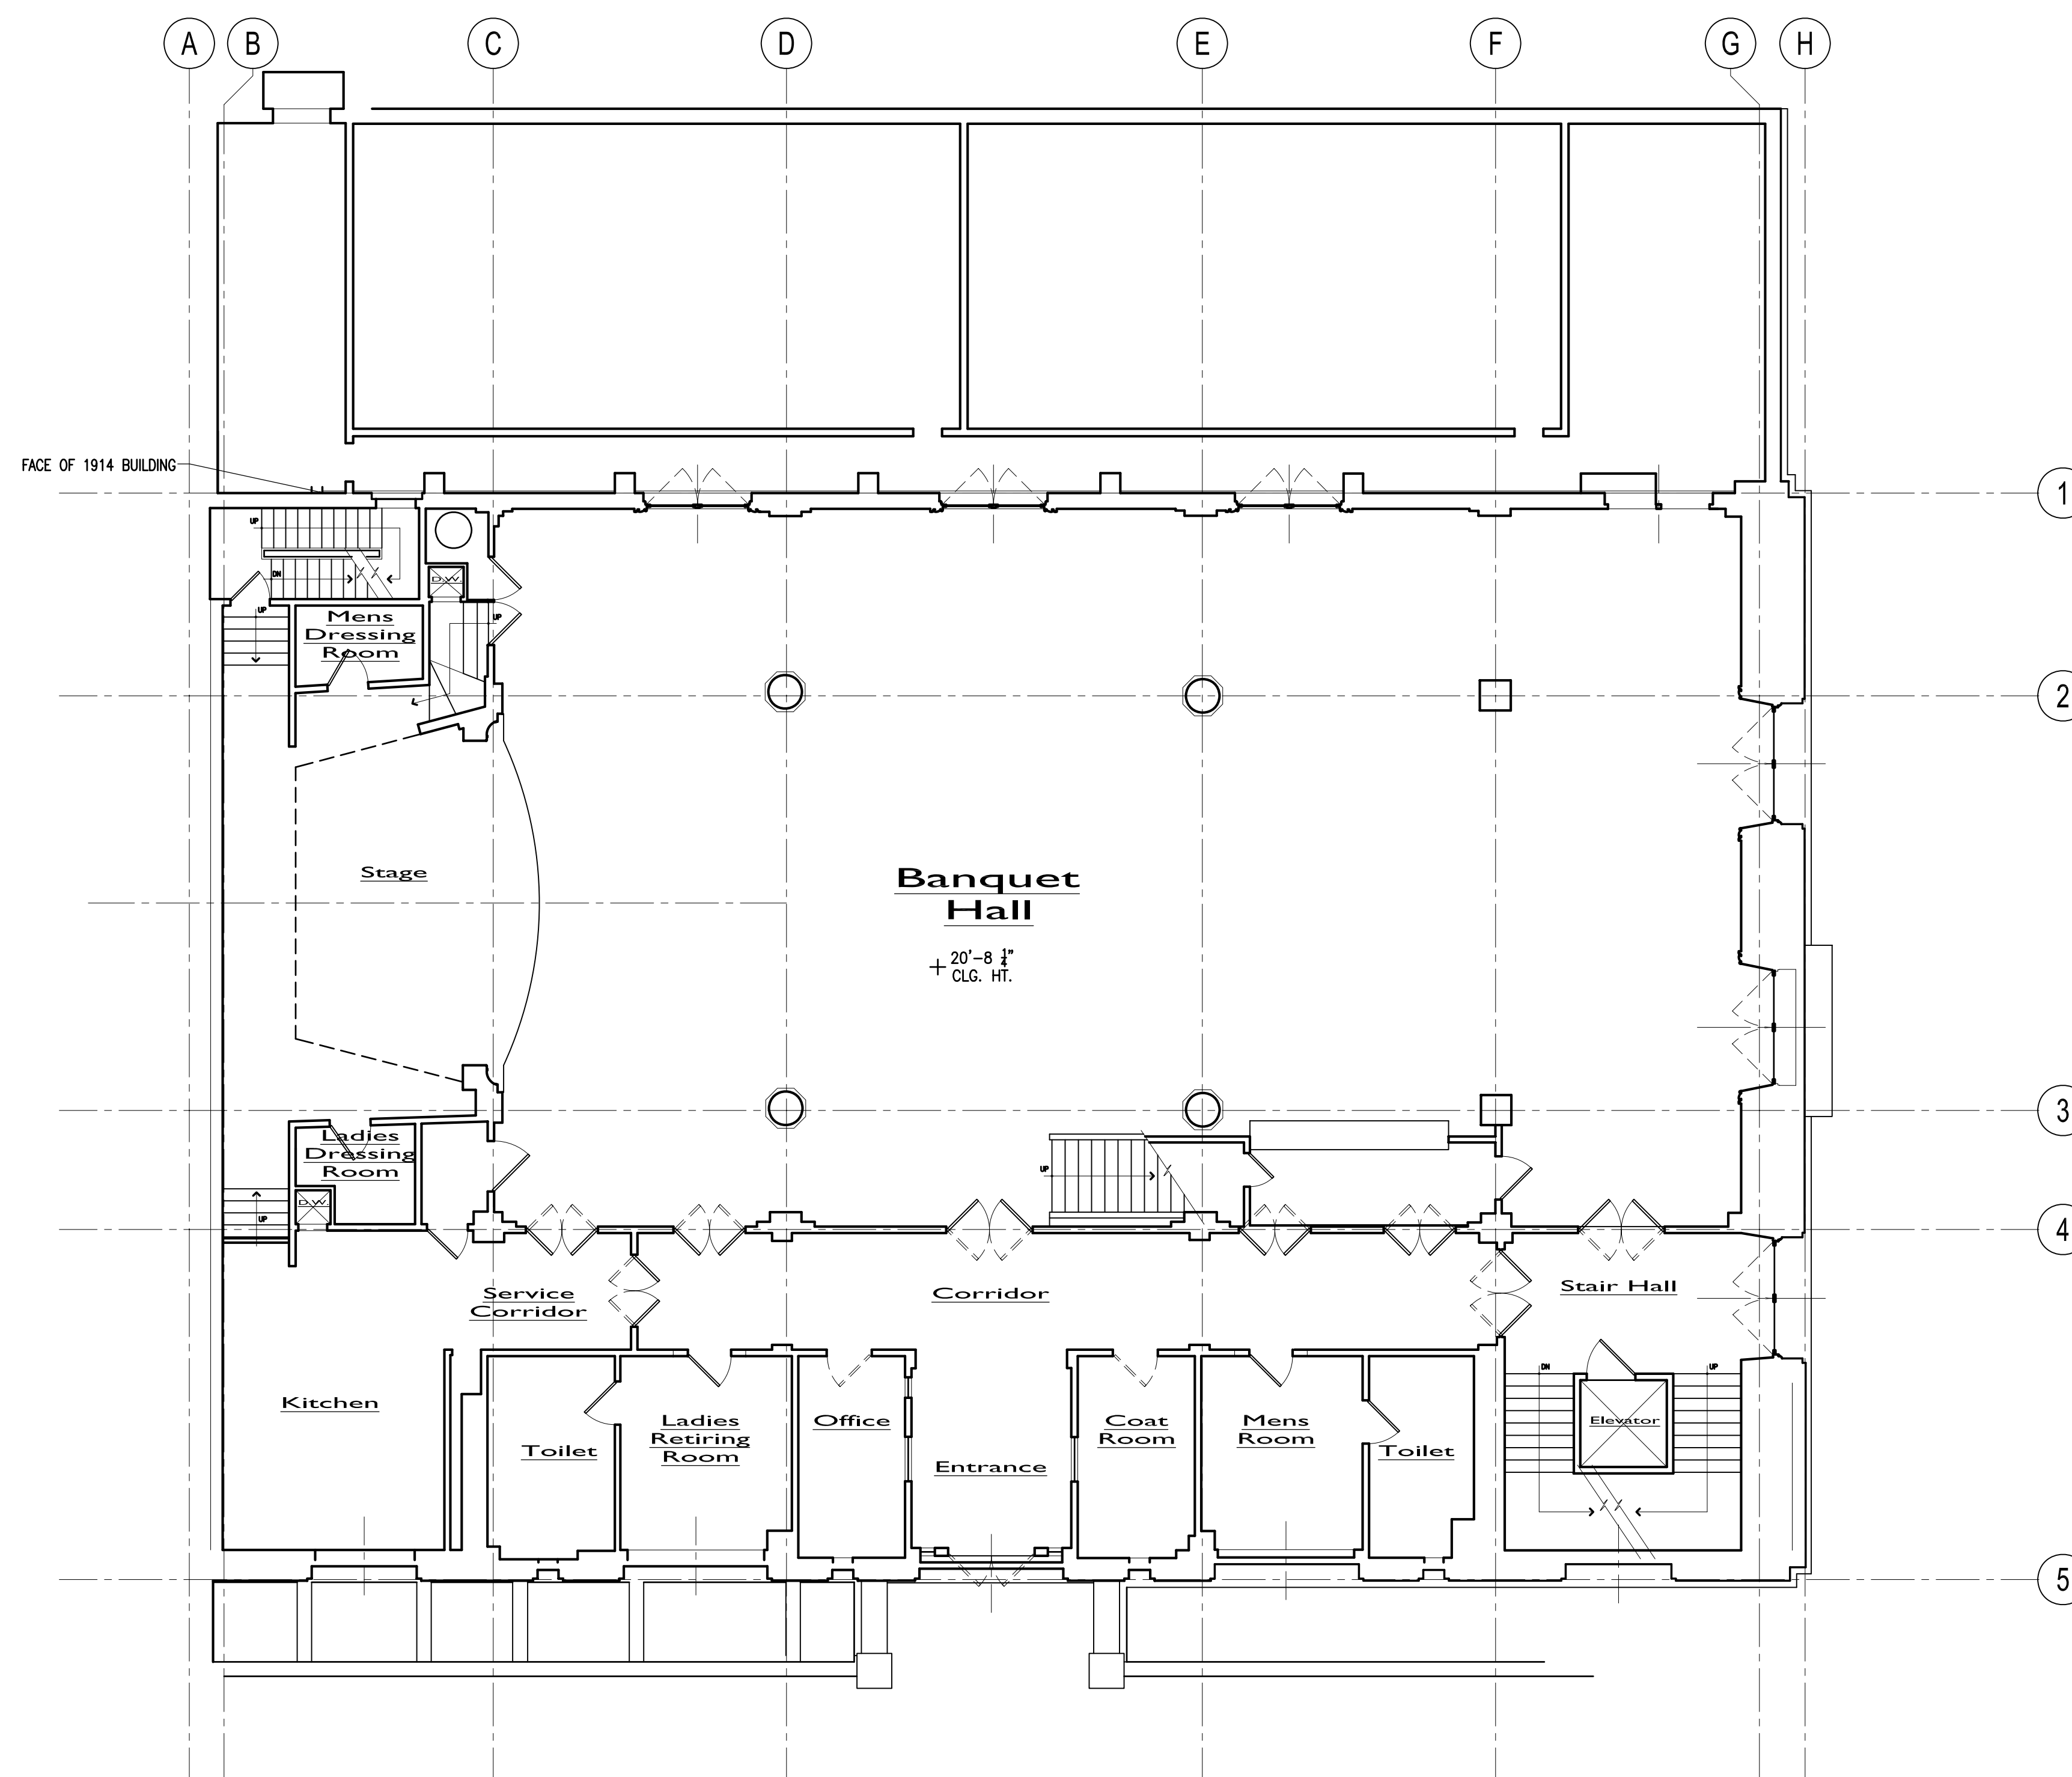

**A SECOND FLOOR PLAN - BANQUET HALL LEVEL**

SCALE: 1/8" = 1'-0"

