



**TACOMA'S  
 HISTORIC  
 ELKS LODGE**

AS-BUILT SET 2007

565 BROADWAY  
 TACOMA, WA 98402



Parcel No. 2005050080  
 2005050070  
 2005050060  
 & 2005050050

**PROGRESS  
 SET**

Project No. 07-002.01  
 Date: September 15, 2007  
 Revisions


Key Plan

**FOURTH  
 FLOOR PLAN**

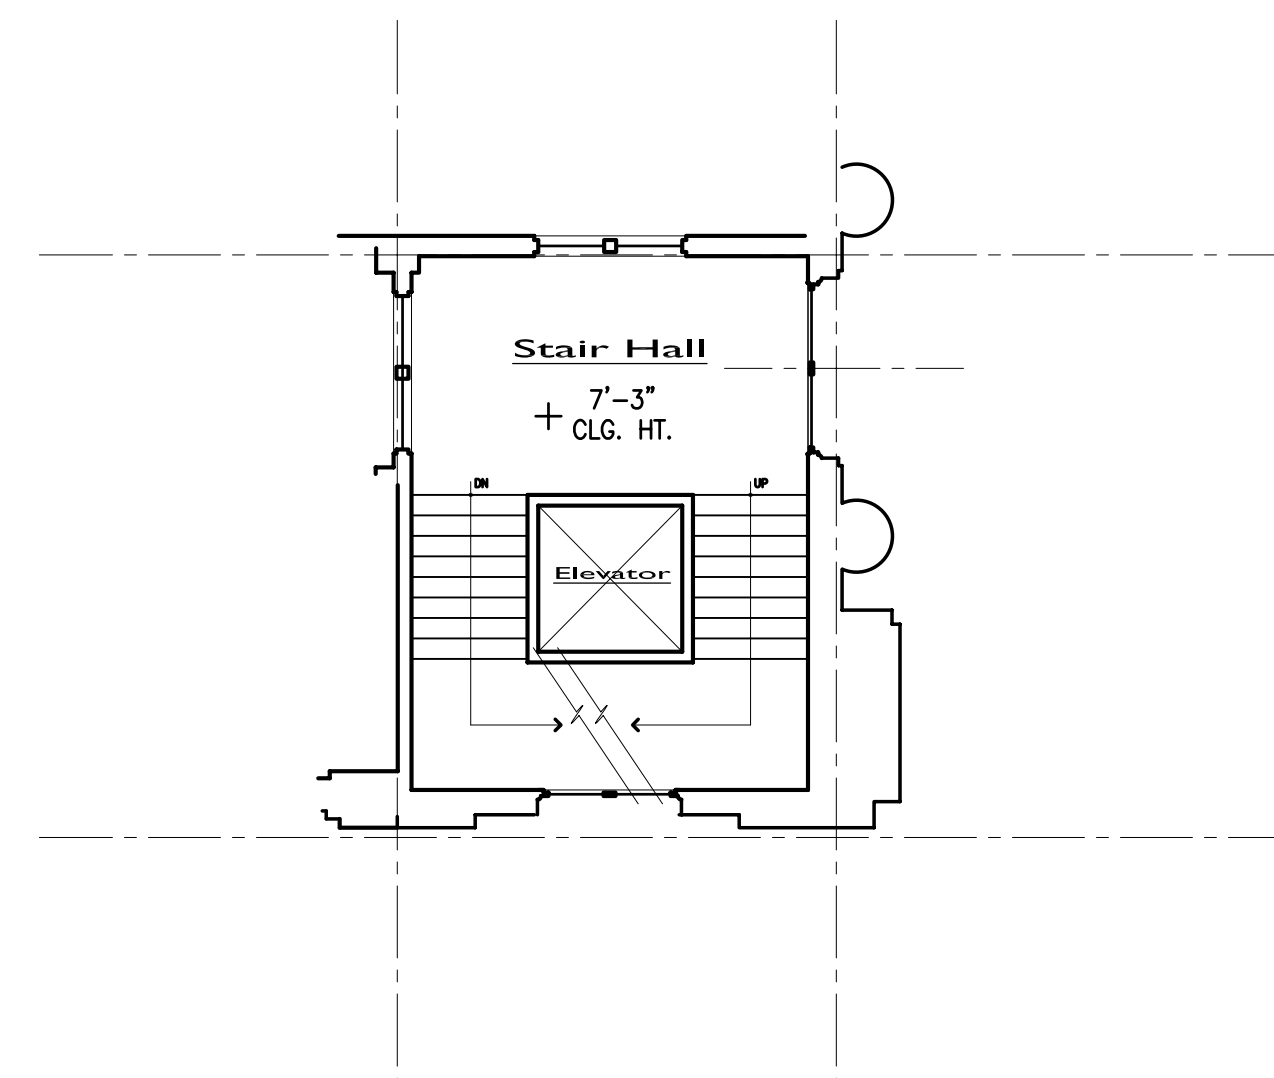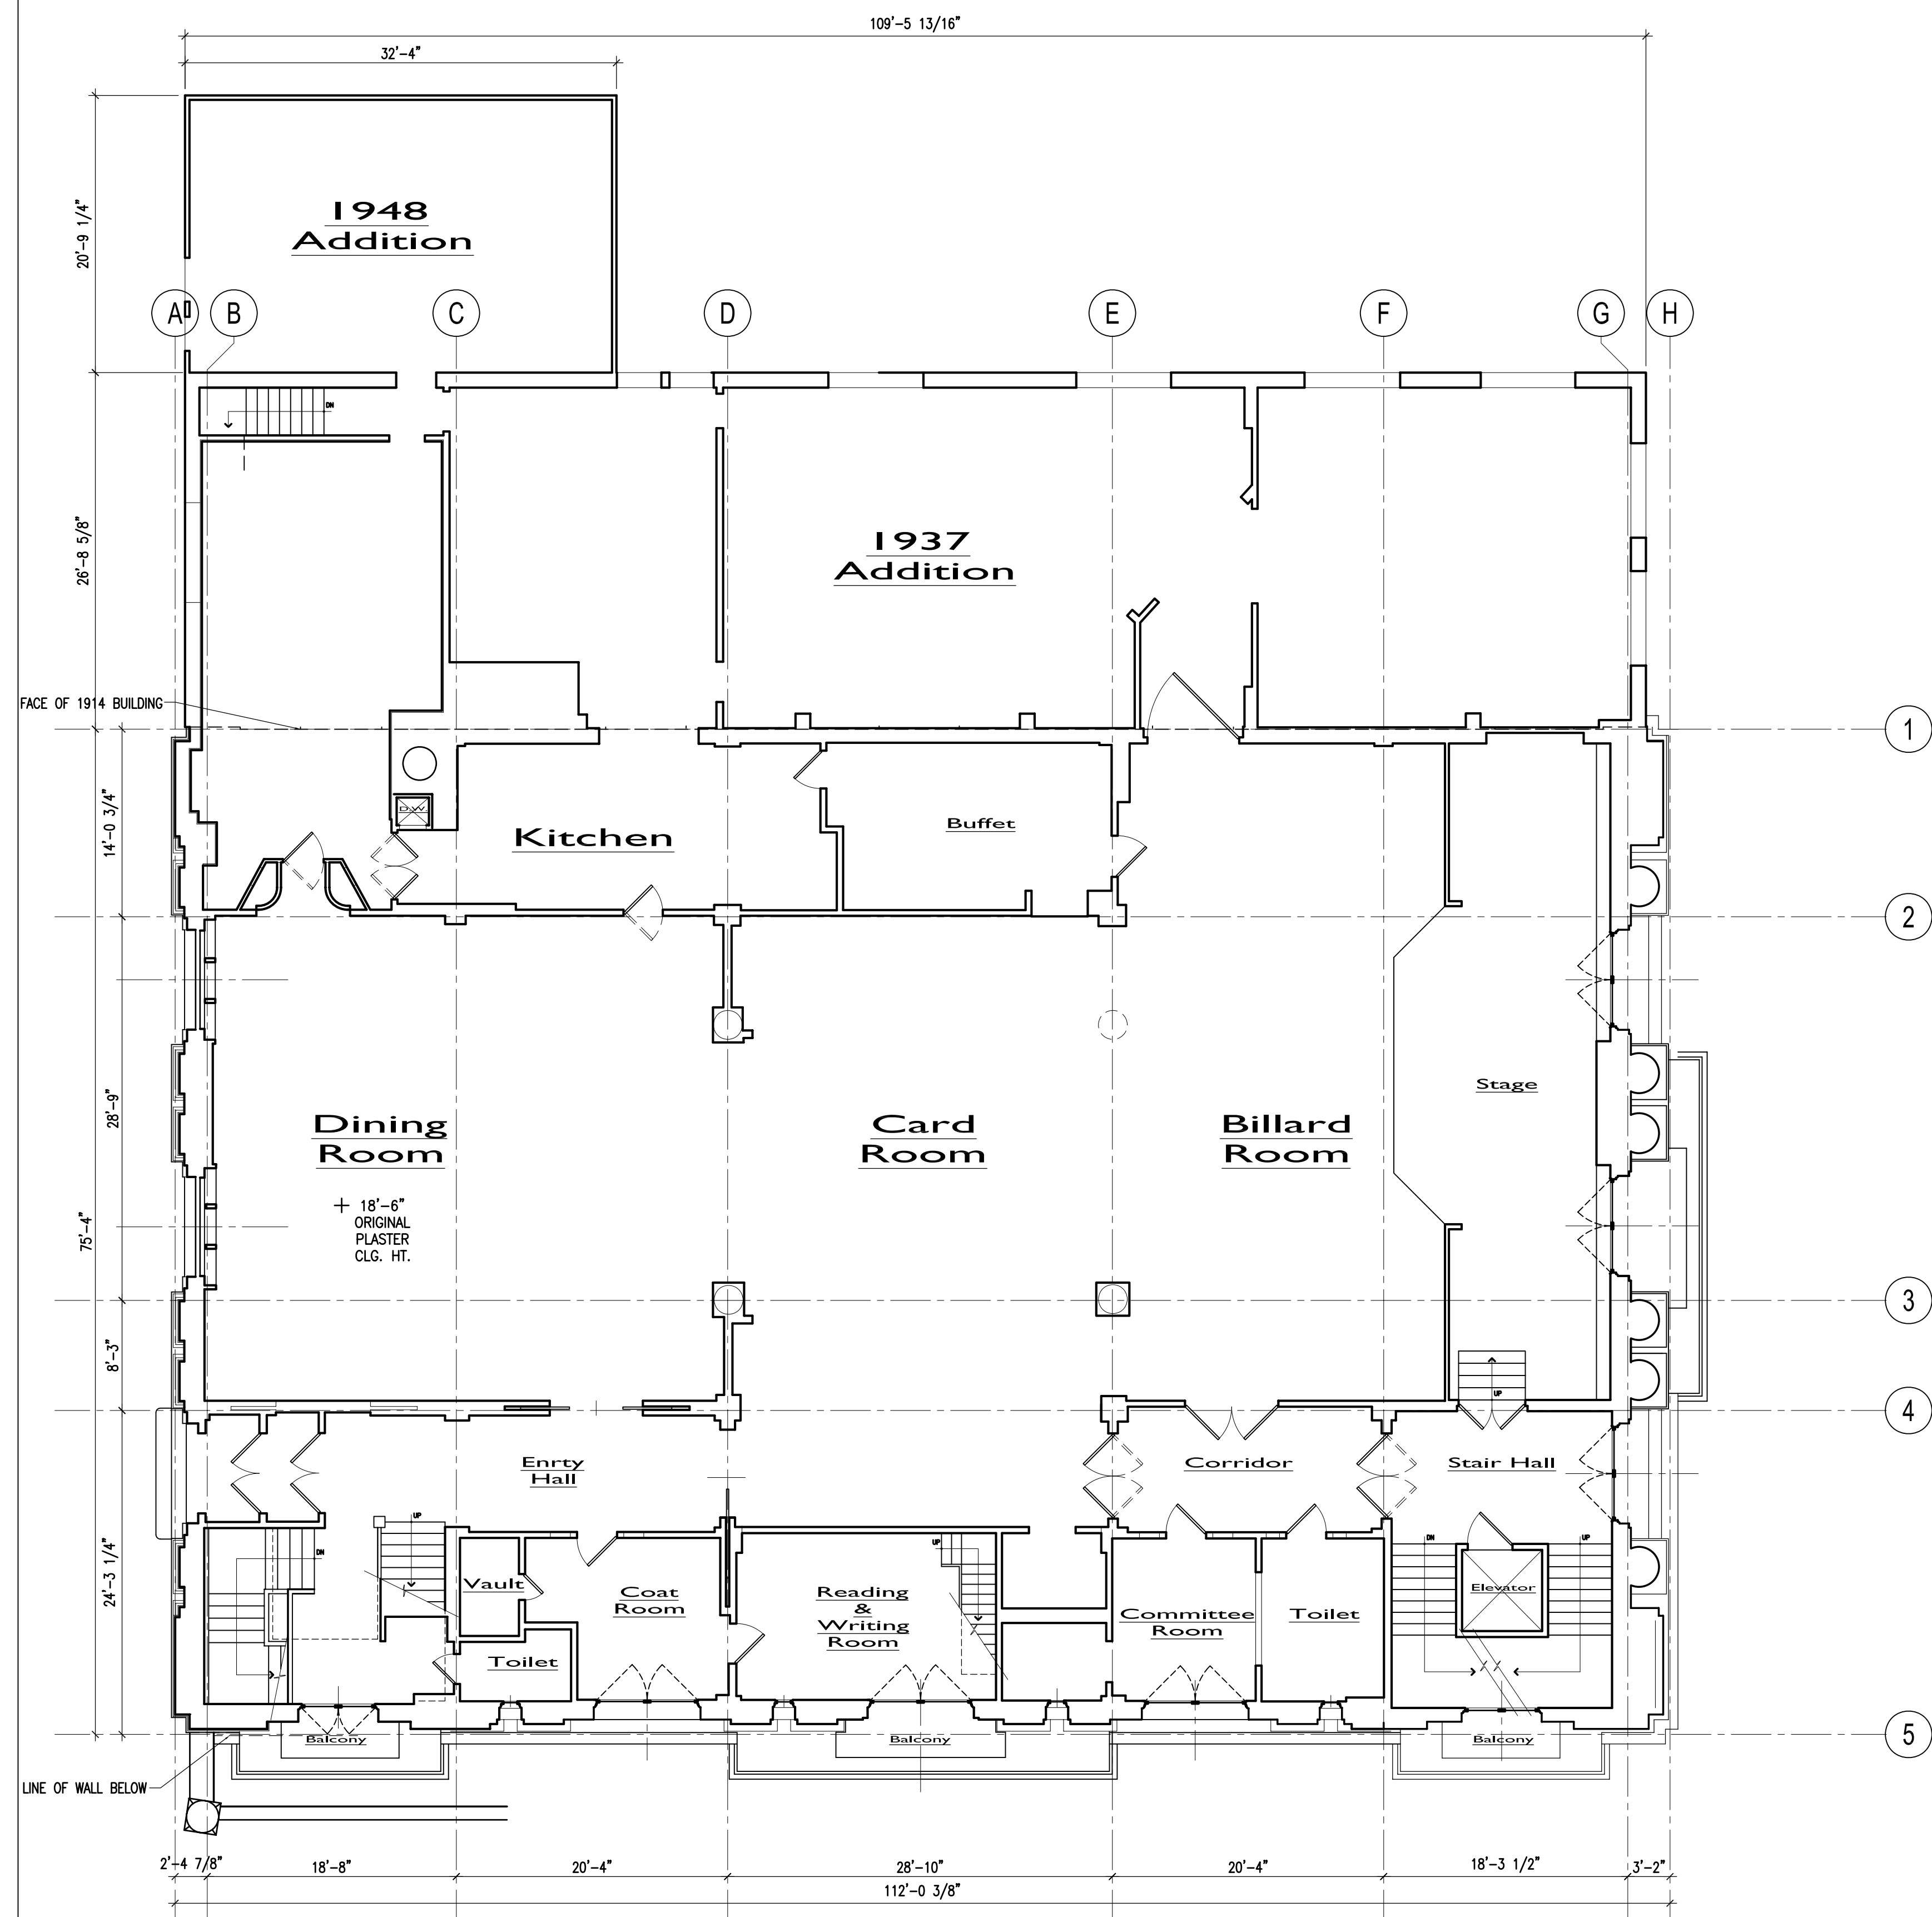

**A FOURTH FLOOR PLAN - DINNING ROOM LEVEL**

SCALE: 1/8" = 1'-0"

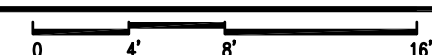

**B MID-FLOOR LANDING ABOVE FOURTH FLOOR**

SCALE: 1/8" = 1'-0"



Dwg Name:  
 RYAN ARCHITECTURE  
 Plot Date: