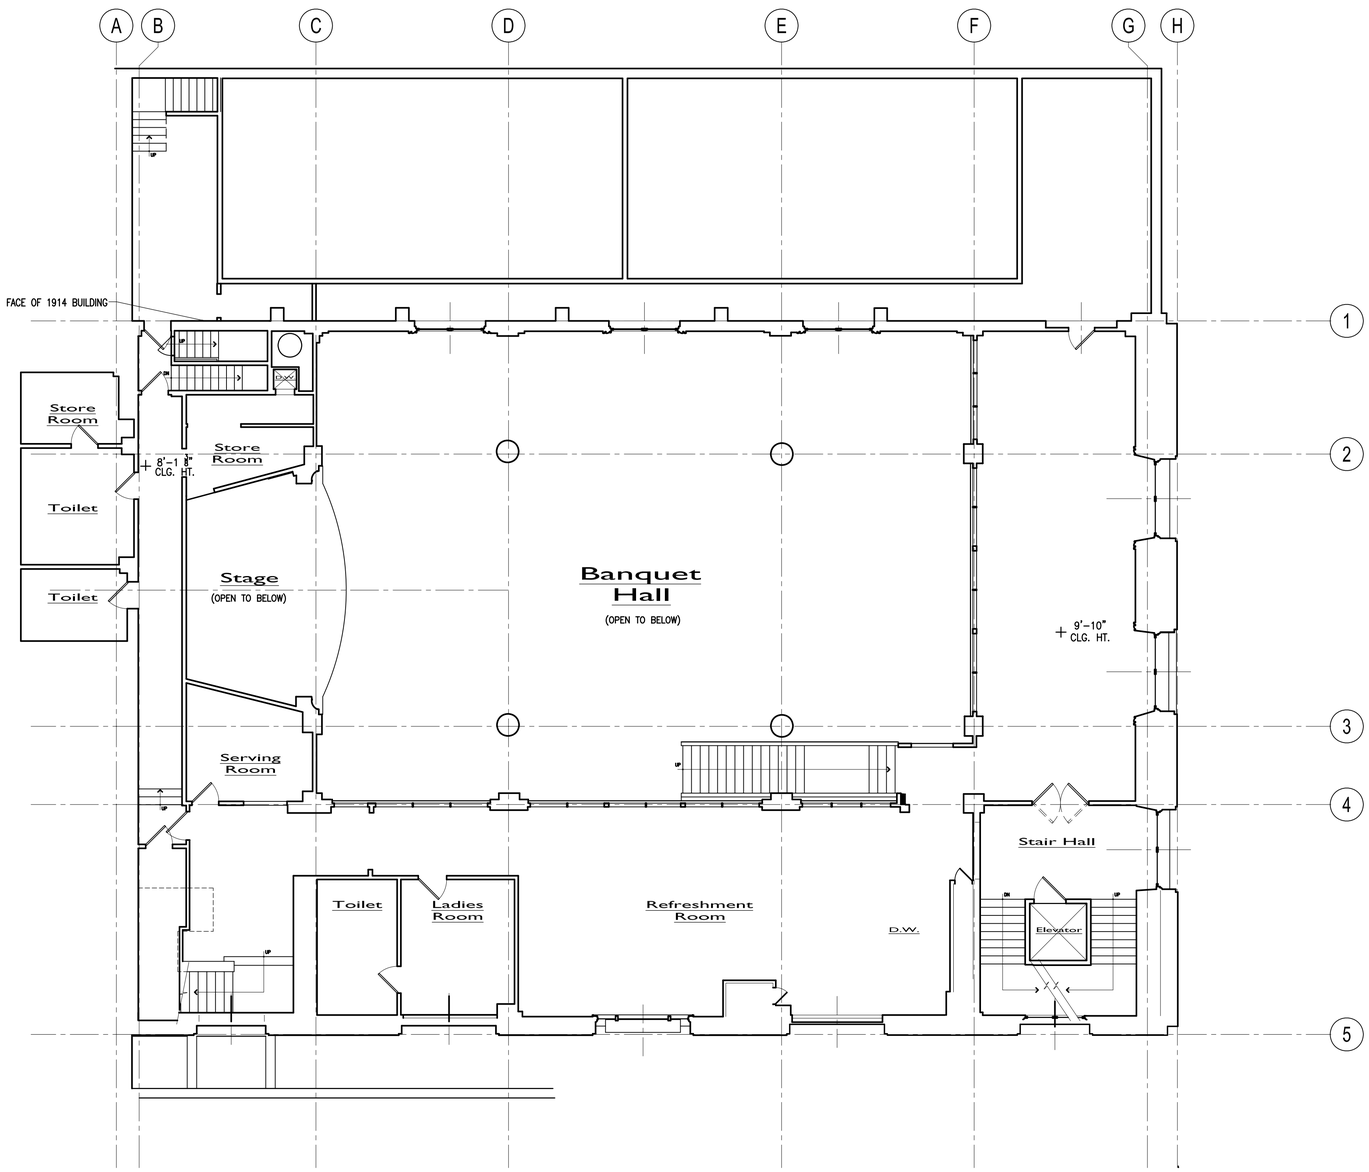

A THIRD FLOOR PLAN - BANQUET MEZZANINE LEVEL

SCALE: 1/8" = 1'-0"

0 4' 8' 16'

REF. N

merritt arch

Architecture
Urban design
Planning

Merritt Arch pllc
1901 Market
Tacoma, Washington
98402-3107
T. 253.383.5300
F. 253.383.5600
e. merritt@merrittarch.com

RYAN ARCHITECTURE
PLANNING &
INTERIOR DESIGN

3017 NORTH 13TH ST.
TACOMA, WA 98406

V/F 253.759.0161

TACOMA'S
HISTORIC
ELKS LODGE

AS-BUILT SET 2007

565 BROADWAY
TACOMA, WA 98402

Parcel No. 2005050080
2005050070
2005050060
& 2005050050

PROGRESS
SET

Project
No. 07-002.01

Date: September 15, 2007

Revisions

Key Plan

THIRD
FLOOR PLAN

A1.3

RYAN ARCHITECTURE
Plot Date:
Dwg Name: